AS-BUILT SITE PLAN

SUNSHINE SQUARE
COMMERCIAL CONDOMINIUMS
IN
HAMPTON, N.H.

SCALE: 1" = 15' NOV. 1981

PARKER SURVEY ASSOC., INC.

EXETER & SEABROOK, N.H.

0 15 15 30 45 60

0 5 10 15

I, RICHARD K. PARKER, JR. A N.H. REGISTERED LAND SURVEYOR, HEREBY CERTIFY THAT THIS SITE PLAN IS ACCURATE AND IN COMPLIANCE WITH THE PROVISIONS OF R.S.A. 356-B:20-I. ALL UNITS DEPICTED HEREON ARE EXISTING.

Richard K. Parker Jr.

FOR RECORDING PURPOSES ONLY
HAMPTON PLANNING BOARD

DATE: _____

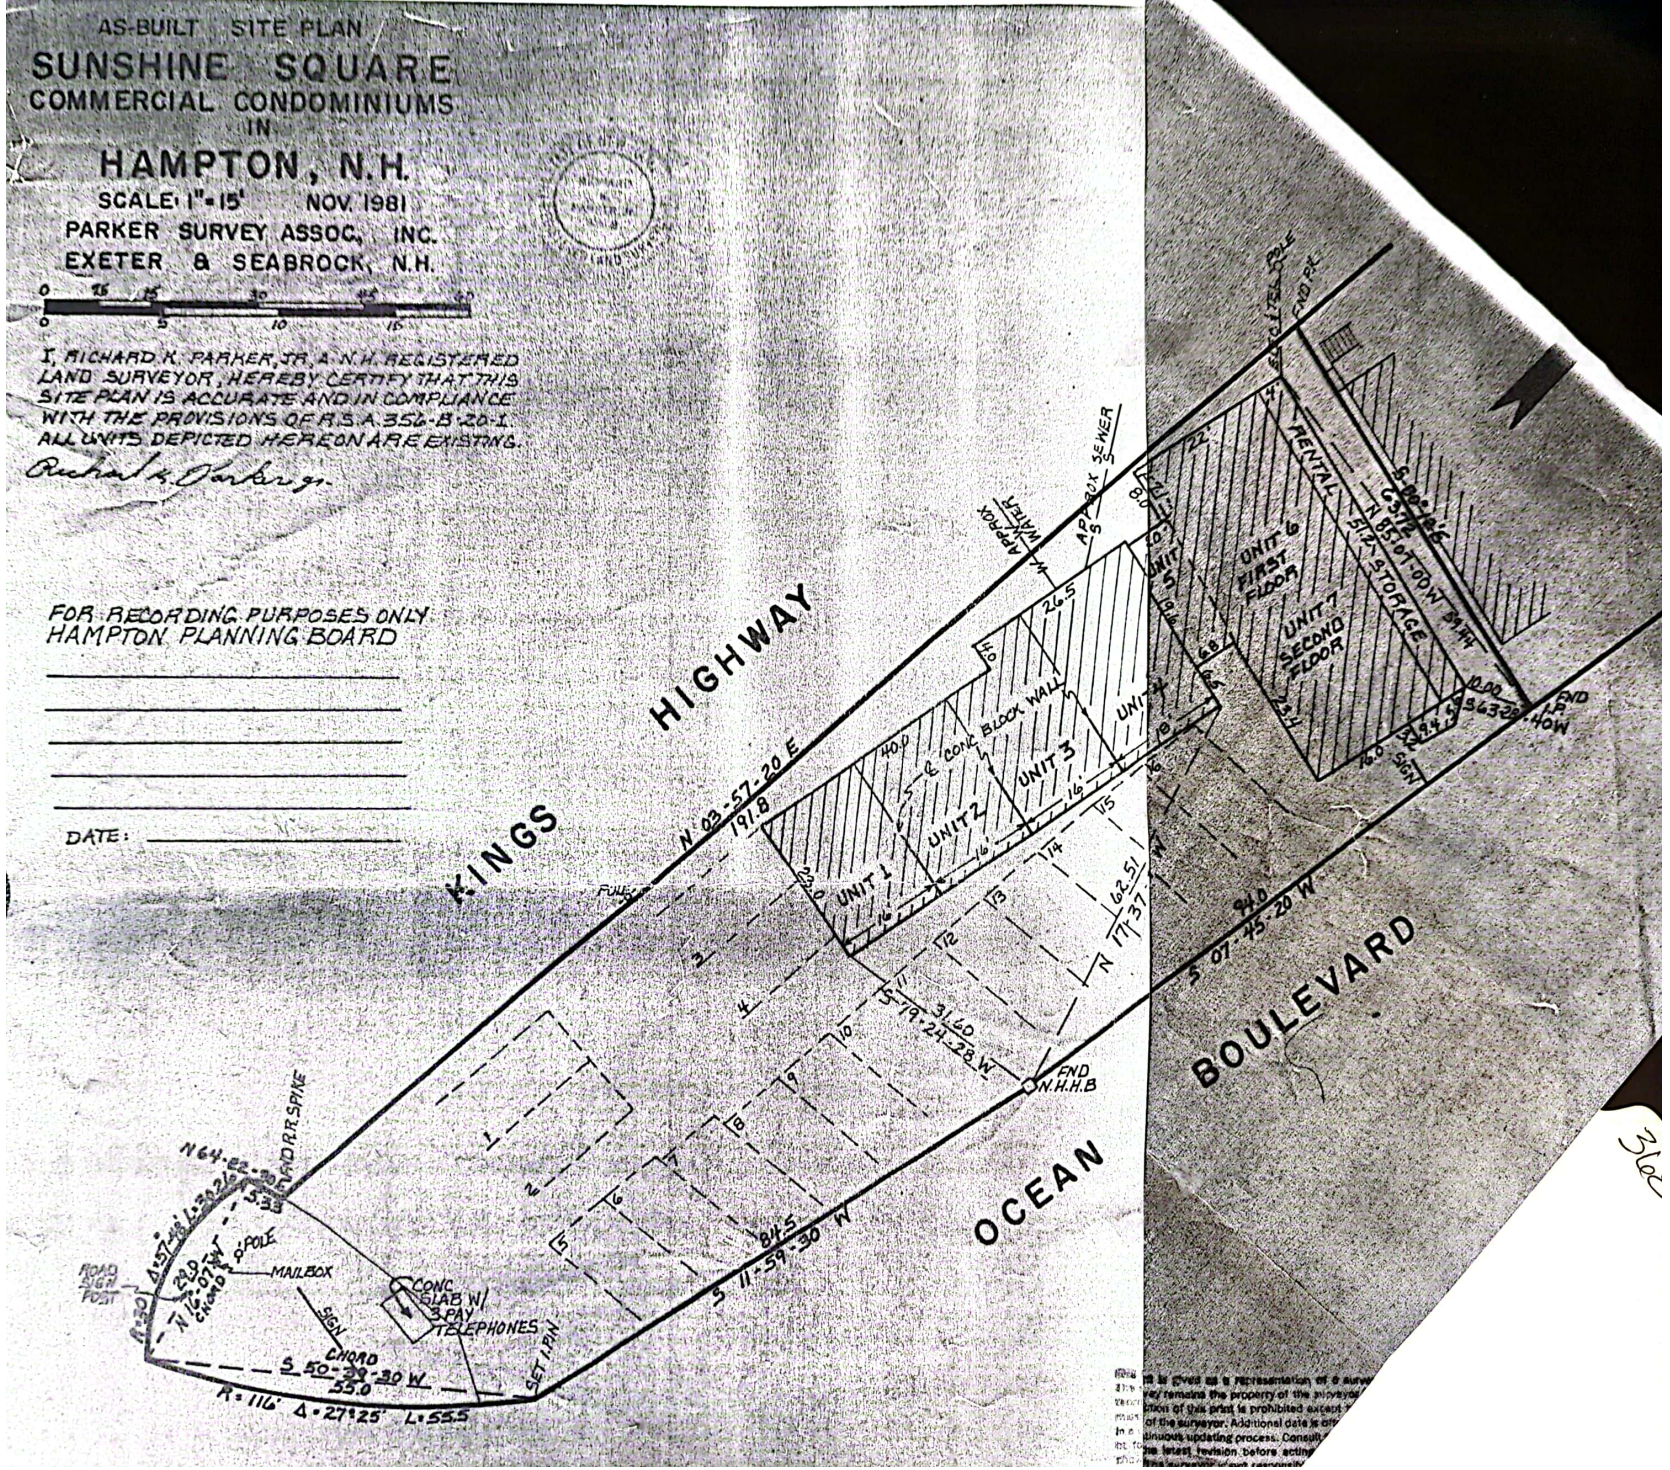

...is given as a representation of a survey... remains the property of the surveyor... of this print is prohibited except ... of the surveyor. Additional data is on... continuous updating process. Consult ... the latest revision before acting...

Blo

Ocean Blvd –
No tour jurisdiction
No

Randy will give me
old state driveway permit

1/16 Randy talked to Doug Mellin
no backing out across st
Everybody backs out
– OK to back out – ?
CLEANER
– Steve Els –

OK w/ Doug Mellin

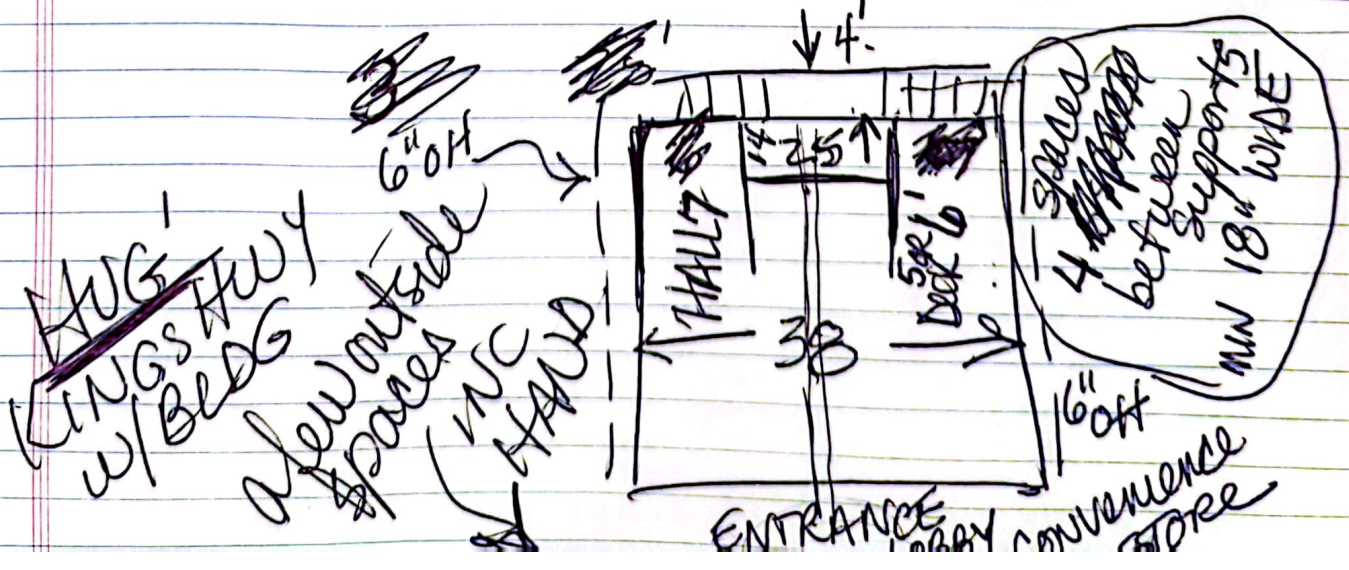

CONCEPT PLAN
1"=20'

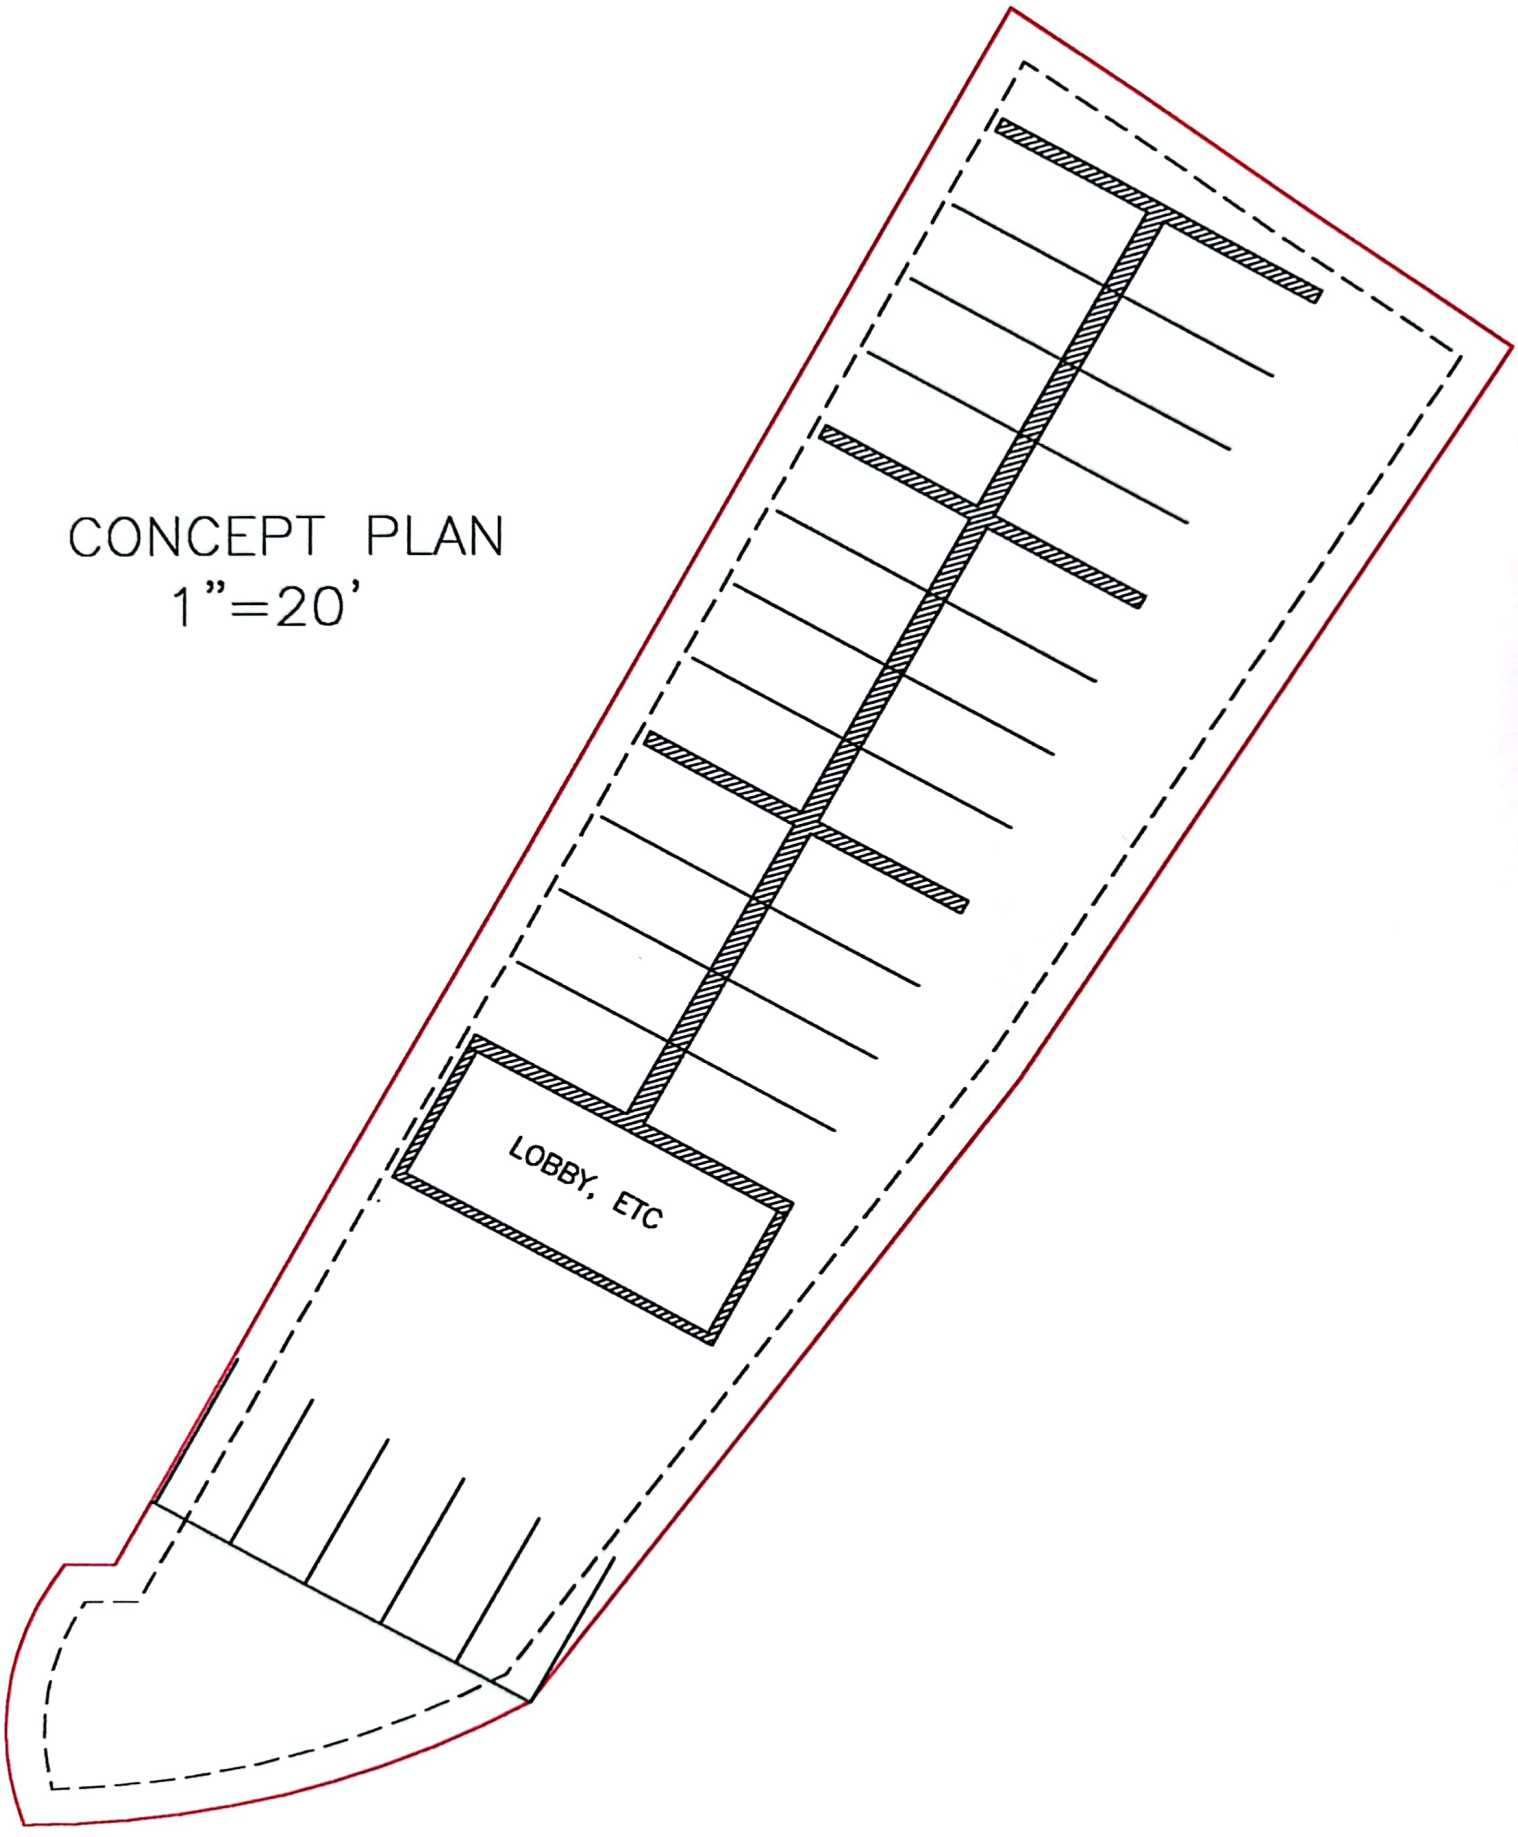

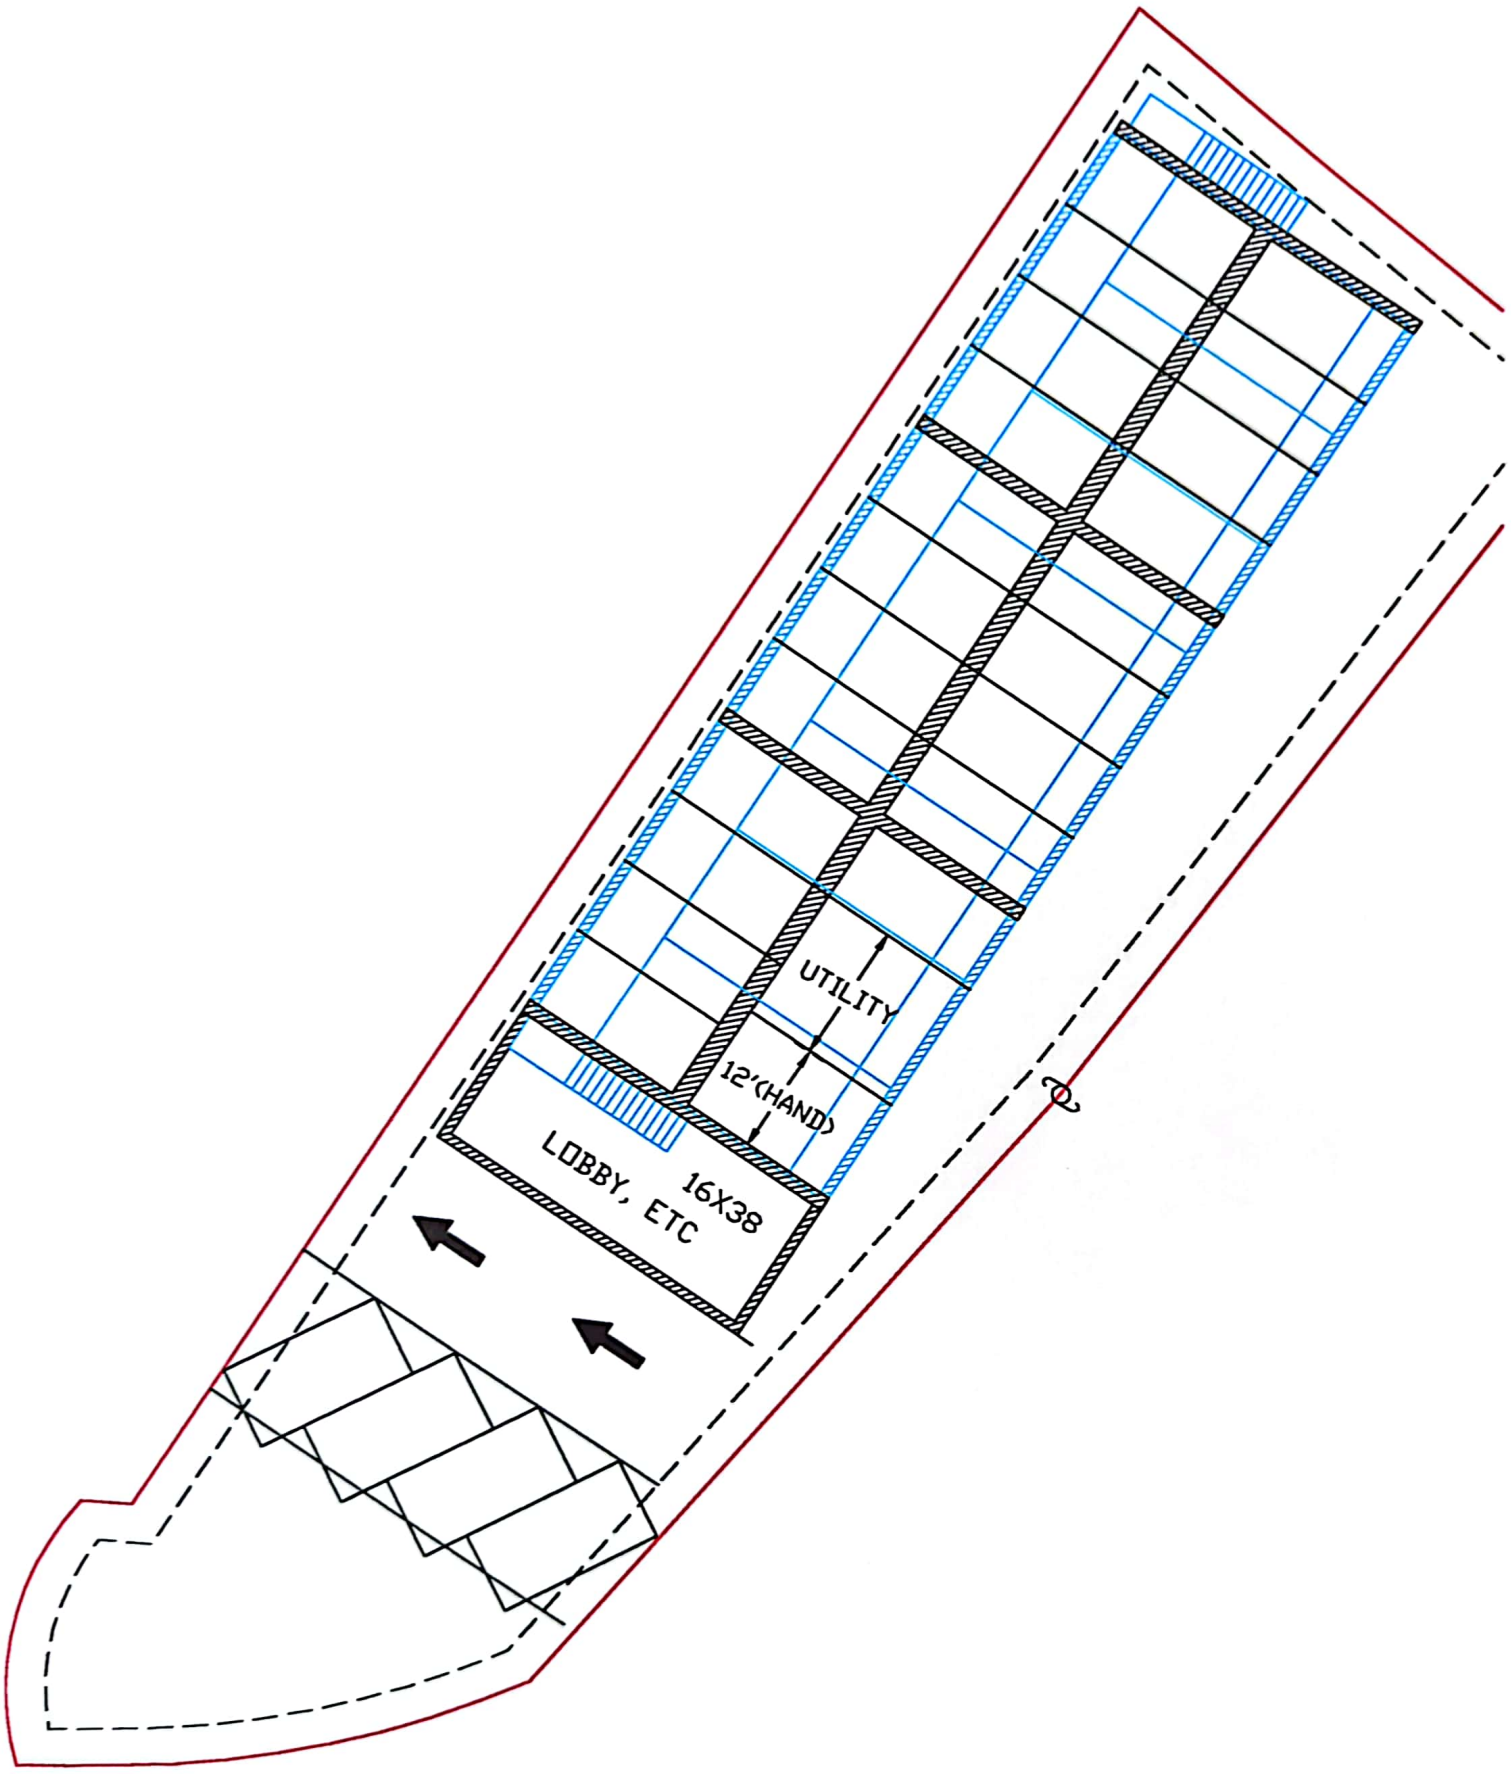
UTILITY
12'(HAND)
LOBBY, ETC
16X38

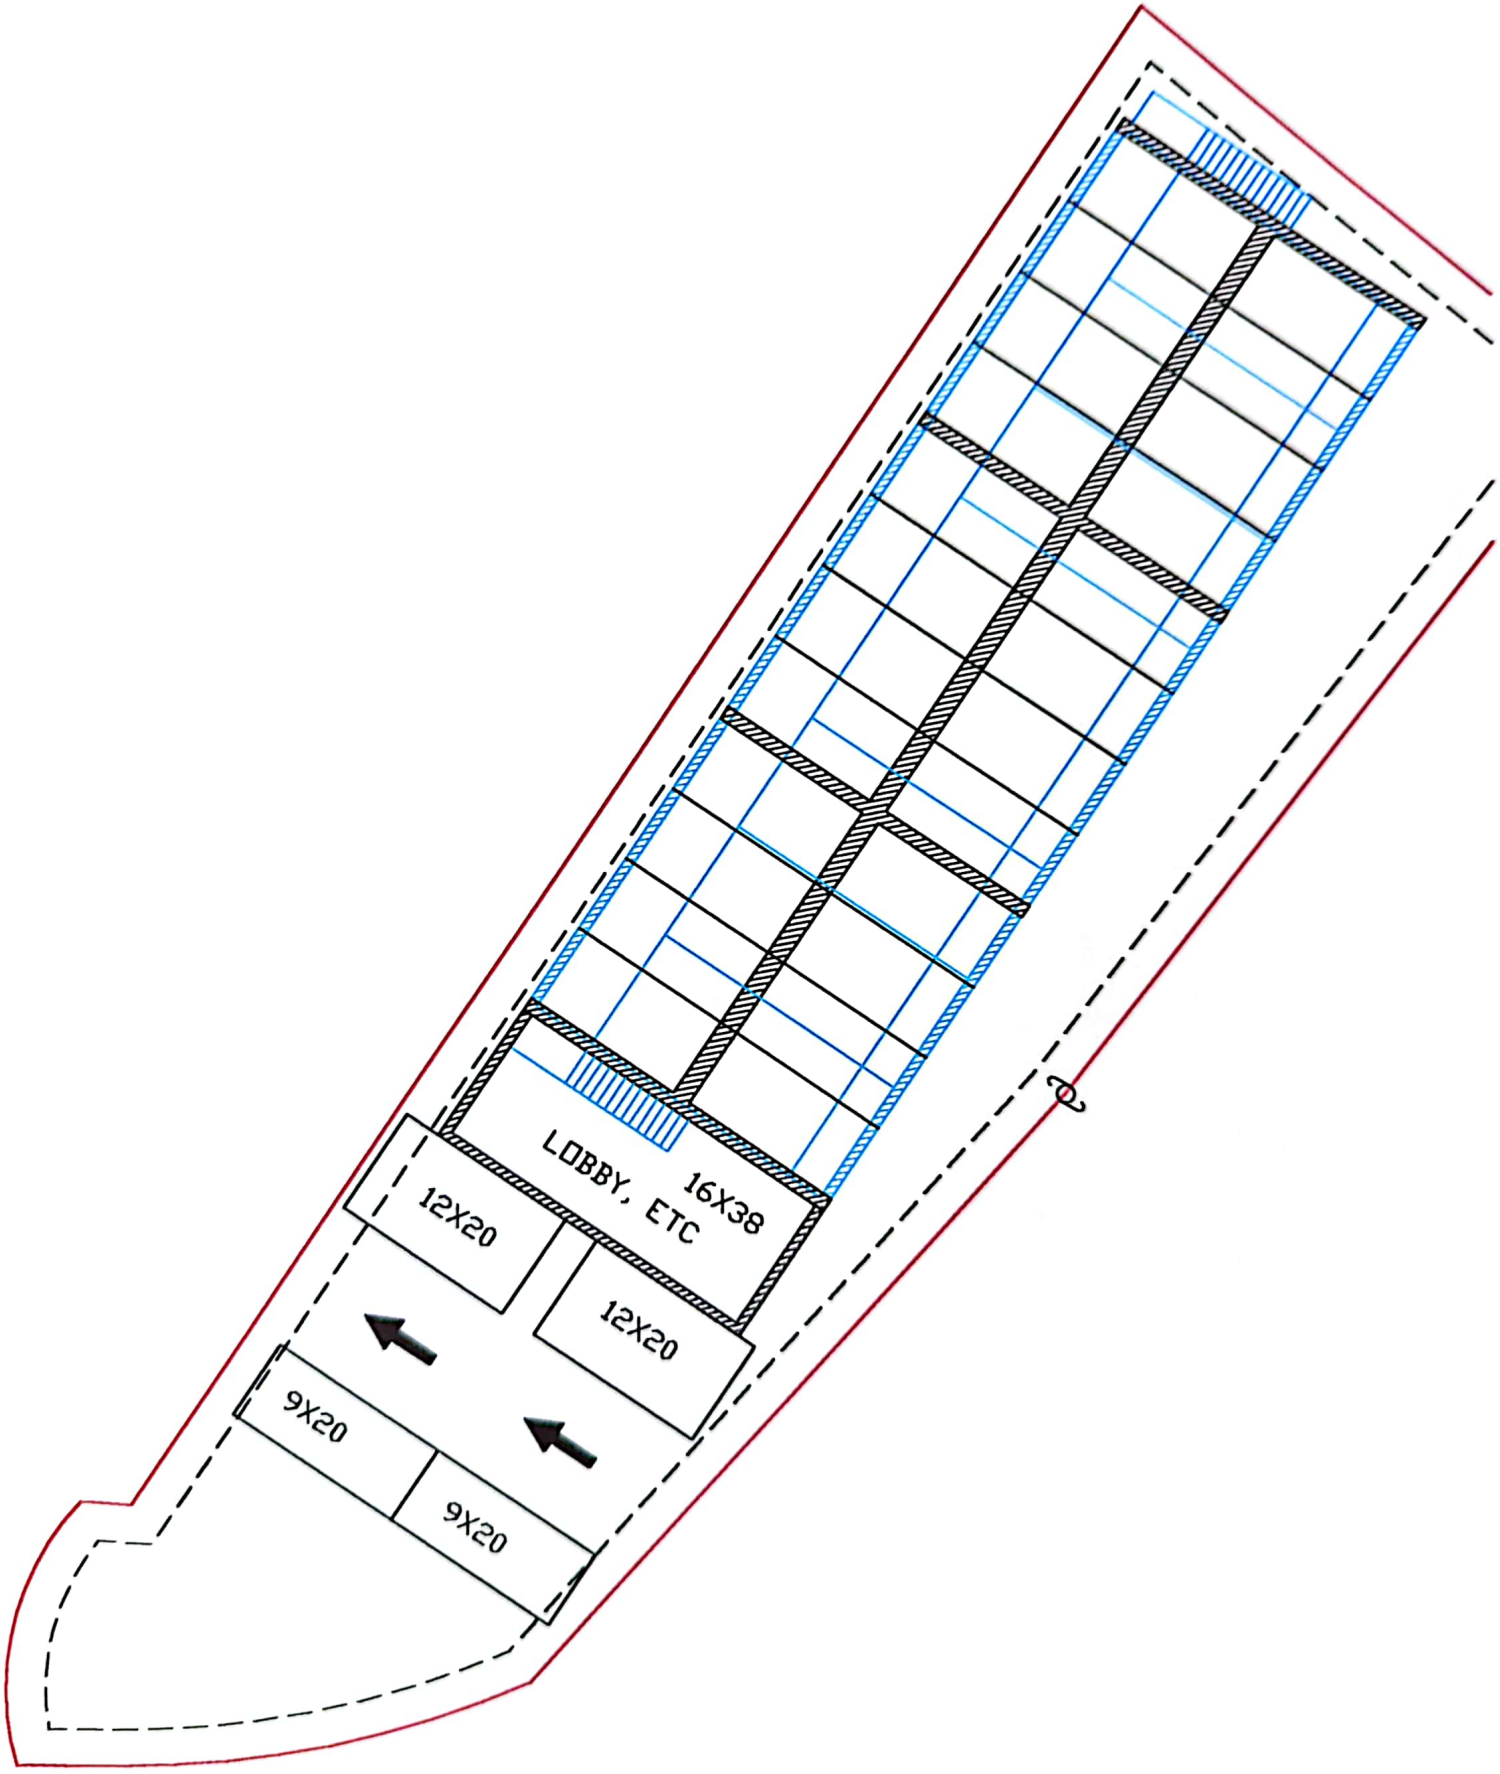
LOBBY, ETC
16X38
12X20
12X20
9X20
9X20

Classic
Garden Accents

Randy Radkay

Factory
124 Lafayette Rd.
Hampton Falls, NH

Mailing Address
PO Box 667
Hampton Falls, NH 03844

(603) 926-3700 • Fax (603) 926-6697
www.classicgardenaccents.com

cell 235-4494

Randy business
says seasonal
Bldg 30' wide
Pole 15' @ hwy RWD
leave 3' on
either
side of RWD